

AMENDMENT NO. 1 TO CELL SITE LEASE (CITY AGREEMENT NO. 7066)

This Amendment No. 1 to Cell Site Lease (City Agreement No. 7066) (hereinafter "Amendment") is dated this ____ day of _____, 2013, by and between the City of Napa, a municipal corporation (hereinafter "Landlord"), and New Cingular Wireless, PCS, LLC, a Delaware limited liability company (hereinafter "Tenant").

RECITALS

A. Landlord and Tenant's predecessor in interest, Napa Cellular Telephone Company, a California general partnership, entered into that certain Lease entitled "Cell Site Lease" dated May 16, 1997, City of Napa Agreement Number 7066 (hereinafter "Lease"), by which the Tenant agreed to lease certain premises, therein described, that are a portion of the real property located at 1542 Foster Road in Napa, California. Tenant's predecessor in interest assigned the Lease to Tenant.

B. Tenant has requested certain amendments and modifications to the Lease to modify the rent payment amount, to modify the notice section, and to replace Exhibit B to the Lease with an updated Exhibit B-1 to allow for changes, additions, modifications and relocations of antennas, equipment and associated cabling.

C. Landlord and Tenant wish to amend the Lease as set forth below.

NOW, THEREFORE, IN CONSIDERATION OF THE MUTUAL COVENANTS AND CONDITIONS IDENTIFIED HEREIN, THE PARTIES HEREBY AGREE AS FOLLOWS:

1. INCORPORATION BY REFERENCE. This Amendment hereby incorporates by reference all terms and conditions set forth in the Lease, unless specifically modified by this Amendment. All terms and conditions set forth in the Lease which are not specifically modified by this Amendment shall remain in full force and effect.

2. AMENDMENT. Commencing on the first day of the month following the date that both Tenant and Landlord have executed this Amendment, the then current Rent shall be increased by One-Hundred and No/100 Dollars (\$100.00) per month, subject to further adjustments as provided in the Lease.

3. AMENDMENT. Section 9 of the Lease is hereby deleted in its entirety and replaced with the following:

9. Notices

All notices, requests, demands and communications hereunder will be given by first class certified or registered mail, return receipt requested, or by a nationally recognized overnight courier, postage prepaid, to be effective when properly sent and received, refused or returned undelivered. Notices will be addressed to the parties as follows.

If to Landlord: City of Napa
PO Box 660
Napa, CA 94559-0660
Attn: Real Estate Manager

Or if sent by a nationally recognized overnight courier:

City of Napa, Public Works Dept.
1600 First Street
Napa, CA 94559
Attn: Real Estate Manager

If to Tenant: New Cingular Wireless PCS, LLC
Attn: Network Real Estate Administration
Re: Cell Site #: CCL00829
Cell Site Name: Hwy 12 & Hwy 29 (CA)
Fixed Asset No: 10087981
Suite 13-F West Tower
575 Morosgo Drive NE
Atlanta, GA 30324

With a copy to:

New Cingular Wireless PCS, LLC
Attn: AT&T Legal Department - Network
Re: Cell Site #: CCL00829
Cell Site Name: Hwy 12 & Hwy 29 (CA)
Fixed Asset No: 10087981
208 S. Akard Street
Dallas, TX 75202-4206

The copy sent to the AT&T Legal Department is an administrative step which alone does not constitute legal notice. Either party hereto may change the place for the giving of notice to it by thirty (30) days prior written notice to the other as provided herein.

4. AMENDMENT. Exhibit B of the Lease, "Site Plan", is hereby deleted in its entirety and replaced with a new Exhibit, attached to this Amendment as Exhibit B-1, attached hereto and incorporated herein by reference.

5. AMENDMENT. Section 5 of the Lease is hereby amended to include the following additional language:

D. Tenant acknowledges and understands that the Premises is secured by Landlord's alarm system and that Tenant's right of access to the Premises is subject to the reasonable security requirements of Landlord. Tenant and Tenant's employees, agents, subcontractors, and invitees shall provide Landlord twenty-four (24) hours' notice of its intent to access the Premises. Failure of Tenant and Tenant's employees, agents, subcontractors, or invitees to notify Landlord of its intended access shall result in a charge in the amount of Three-Hundred and No/100 Dollars (\$300) payable by Tenant to Landlord as liquidated damages to cover the expense of time and materials incurred by Landlord to respond to alarms activated by Tenant's unauthorized entry.

6. ENTIRE LEASE. This Amendment (including the Lease as amended herein and all documents incorporated herein by reference) comprises the entire integrated understanding between the parties concerning the services described in this Amendment. This Amendment supersedes all prior negotiations, agreements and understandings regarding the subject matter described herein, whether written or oral. The documents incorporated by reference into this Amendment are complementary; what is called for in one is binding as if called for in all.

7. **SIGNATURES.** The individuals executing this Amendment represent and warrant that they have the right, power, legal capacity, and authority to enter into and to execute this Amendment on behalf of the respective legal entities of the Consultant and the Landlord. This Amendment shall inure to the benefit of and be binding upon the parties hereto and their respective successors and assigns.

IN WITNESS WHEREOF, the parties have duly executed this Amendment the day and year first above written.

LANDLORD:

City of Napa, a municipal corporation

(Signature)

Mike Parness, City Manager
(Print name and title)

ATTEST:

(Signature)

Dorothy Roberts, City Clerk
(Type name and title)

COUNTERSIGNED:

(Signature)

Desiree Brun, City Auditor
(Type name and title)

APPROVED AS TO FORM:

(Signature)

Michael W. Barrett, City Attorney
(Type name and title)

Budget Code: 53001-36201

TENANT:

New Cingular Wireless PCS, LLC,
a Delaware limited Liability company

By: AT&T Mobility Corporation
Its: Manager

(Signature)



Michael Guibord
Director
Construction & Engineering
9/27/13

(Print name and title)

(Signature)

(Print name and title)

*Corporation, partnership, limited liability corporation, sole proprietorship, etc. Unless corporate resolution delegates an individual to sign contracts, an agreement with a corporation shall be signed by the President or Vice President **and** the Secretary or Treasurer of the corporation. A general partner shall sign on behalf of a general partnership. The managing member, if authorized, may sign on behalf of a limited liability corporation.

LANDLORD ACKNOWLEDGMENT

State of California
County of _____

On _____ before me, _____
(insert name and title of the officer)

personally appeared _____
who proved to me on the basis of satisfactory evidence to be the person(s) whose name(s) is/are subscribed
to the within instrument and acknowledged to me that he/she/they executed the same in his/her/their
authorized capacity(ies), and that by his/her/their signature(s) on the instrument the person(s), or the entity
upon behalf of which the person(s) acted, executed the instrument.

I certify under PENALTY OF PERJURY under the laws of the State of California that the foregoing
paragraph is true and correct.

WITNESS my hand and official seal.

Signature _____ (Seal)

TENANT ACKNOWLEDGMENT

State of California
County of _____

On _____ before me, _____
(insert name and title of the officer)

personally appeared _____
who proved to me on the basis of satisfactory evidence to be the person(s) whose name(s) is/are subscribed
to the within instrument and acknowledged to me that he/she/they executed the same in his/her/their
authorized capacity(ies), and that by his/her/their signature(s) on the instrument the person(s), or the entity
upon behalf of which the person(s) acted, executed the instrument.

I certify under PENALTY OF PERJURY under the laws of the State of California that the foregoing
paragraph is true and correct.

See attached

WITNESS my hand and official seal.

Signature _____ (Seal)

STATE OF CALIFORNIA

COUNTY OF CONTRA COSTA

On Sept 30, 2013 before me, Kathleen Angela Martic-Kongeaal a Notary Public, personally appeared Michael Guibord who proved to me on the basis of satisfactory evidence to be the person(s) whose name(s) is/~~are~~ subscribed to the within instrument and acknowledged to me that he/~~she/they~~ executed the same in his/~~her/their~~ authorized capacity(ies), and that by his/~~her/their~~ signature(s) on the instrument the person(s), or the entity upon behalf of which the person(s) acted, executed the instrument.

I certify under PENALTY OF PERJURY under the laws of the State of California that the foregoing paragraph is true and correct.


Witness my hand and official seal.

Signature Kathleen Angela Martic-Kongeaal
Printed Name: Kathleen Angela Martic-Kongeaal
My Commission Expires Dec 26, 2014



CCL00829
FA#10087981
HWY 12 & HWY 29

Exhibit B-1
(updated Exhibit B attached)

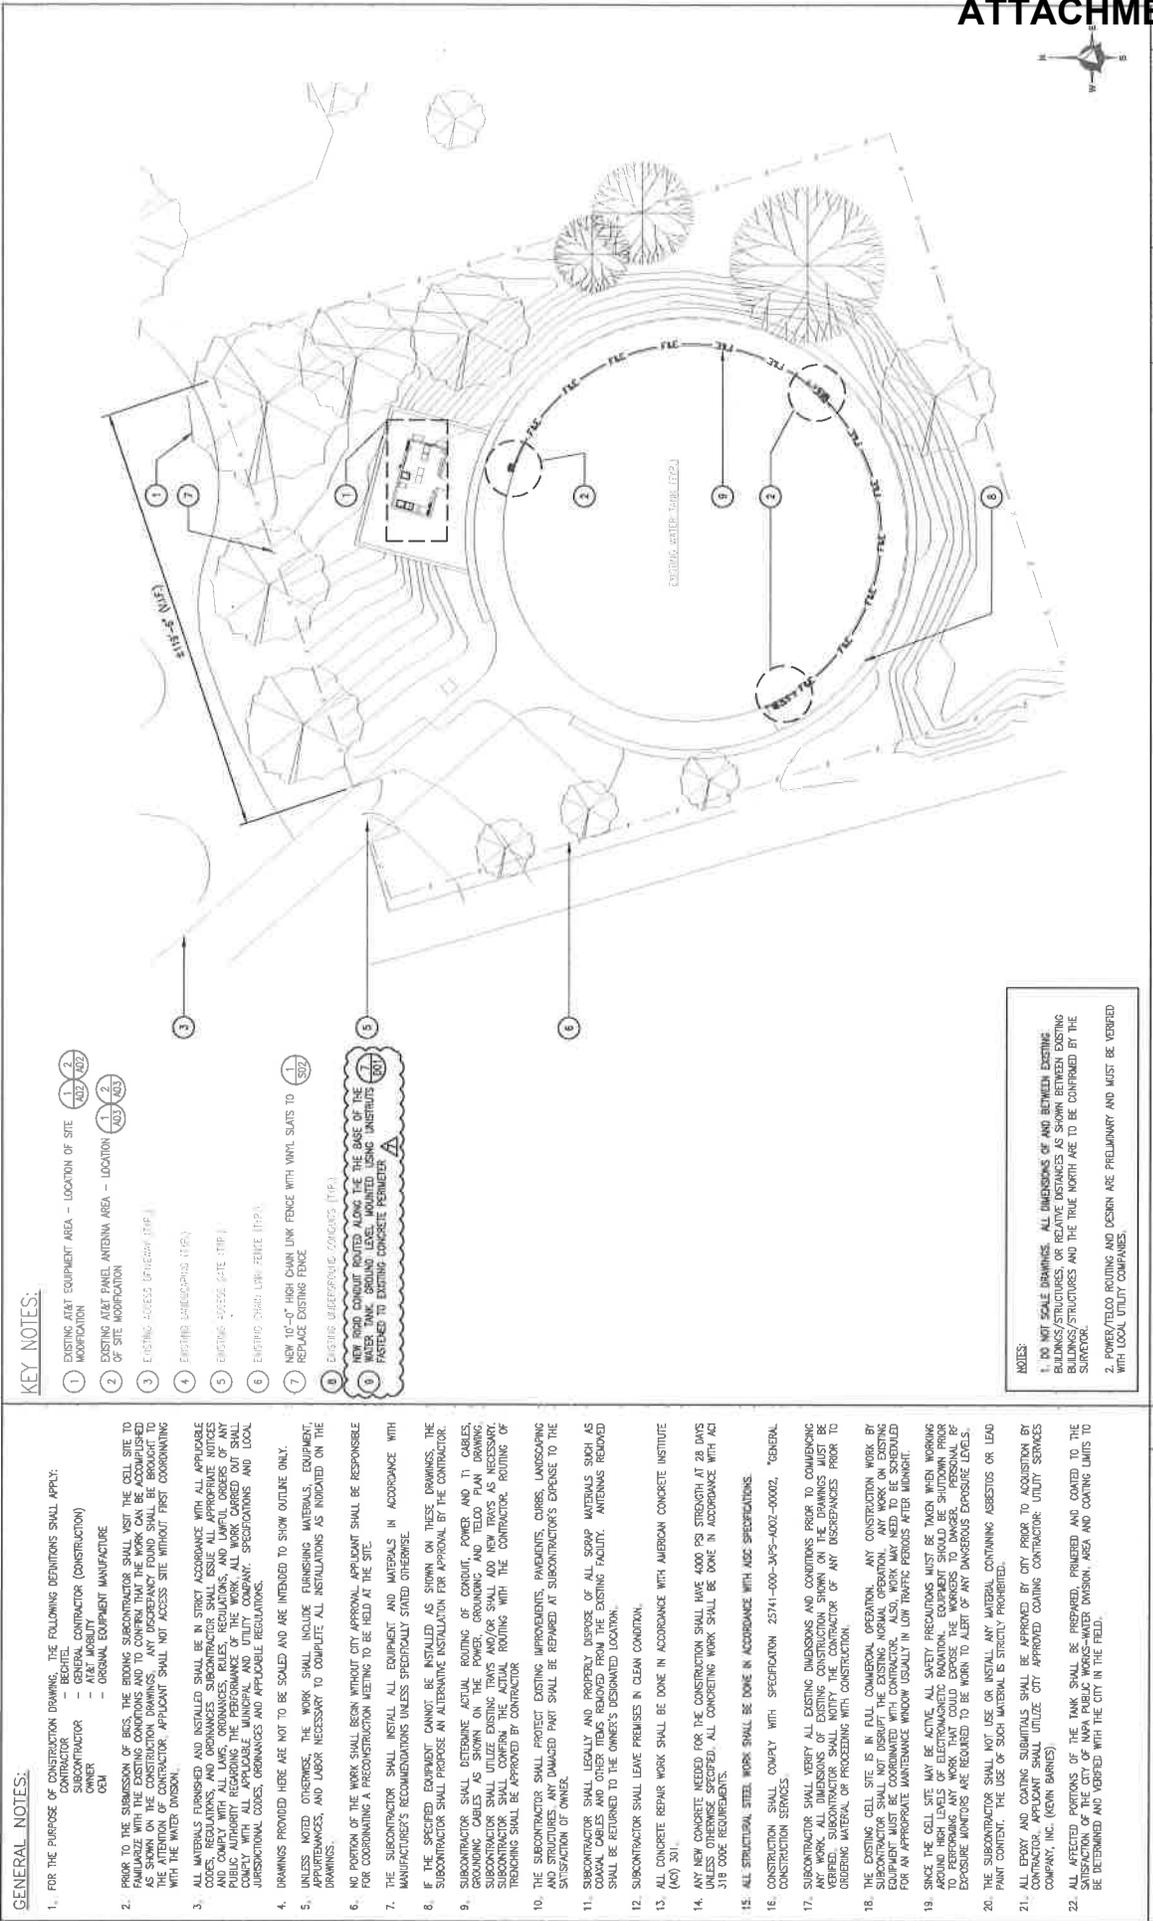

GENERAL NOTES:

1. FOR THE PURPOSE OF CONSTRUCTION DRAWINGS, THE FOLLOWING DEFINITIONS SHALL APPLY:
 CONTRACTOR - BECHTEL
 SUBCONTRACTOR - GENERAL CONTRACTOR (CONSTRUCTION)
 OWNER - AT&T MOBILITY
 OEM - ORIGINAL EQUIPMENT MANUFACTURER
2. PRIOR TO THE SUBMISSION OF BIDS, THE BIDDING SUBCONTRACTOR SHALL VISIT THE CELL SITE TO FAMILIARIZE WITH THE EXISTING CONDITIONS AND TO CONFIRM THAT THE WORK CAN BE ACCOMPLISHED WITHIN THE SPECIFIED TIME FRAME. ANY DISCREPANCIES FOUND SHOULD BE BROUGHT TO THE ATTENTION OF THE CONTRACTOR. APPLICANT SHALL NOT ACCESS SITE WITHOUT FIRST COORDINATING WITH THE WATER DIVISION.
3. ALL MATERIALS FURNISHED AND INSTALLED SHALL BE IN STRICT ACCORDANCE WITH ALL APPLICABLE CODES, REGULATIONS, AND ORDINANCES. SUBCONTRACTOR SHALL ISSUE ALL APPROPRIATE NOTICES AND COMPLY WITH ALL LAWS, ORDINANCES, RULES, REGULATIONS, AND LAWFUL ORDERS OF ANY PUBLIC AUTHORITY REGARDING THE PERFORMANCE OF THE WORK. ALL WORK CARRIED OUT SHALL BE IN ACCORDANCE WITH ALL APPLICABLE AND ENFORCEABLE LOCAL, STATE, FEDERAL AND LOCAL JURISDICTIONAL CODES, ORDINANCES AND APPLICABLE REGULATIONS.
4. DRAWINGS PROVIDED HERE ARE NOT TO BE SCALED AND ARE INTENDED TO SHOW OUTLINE ONLY.
5. UNLESS NOTED OTHERWISE, THE WORK SHALL INCLUDE FURNISHING MATERIALS, EQUIPMENT, APPURTENANCES, AND LABOR NECESSARY TO COMPLETE ALL INSTALLATIONS AS INDICATED ON THE DRAWINGS.
6. NO PORTION OF THE WORK SHALL BEGAIN WITHOUT CITY APPROVAL. APPLICANT SHALL BE RESPONSIBLE FOR COORDINATING A PRECONSTRUCTION MEETING TO BE HELD AT THE SITE.
7. THE SUBCONTRACTOR SHALL INSTALL ALL EQUIPMENT AND MATERIALS IN ACCORDANCE WITH MANUFACTURER'S RECOMMENDATIONS UNLESS SPECIFICALLY STATED OTHERWISE.
8. IF THE SPECIFIED EQUIPMENT CANNOT BE INSTALLED AS SHOWN ON THESE DRAWINGS, THE SUBCONTRACTOR SHALL PROPOSE AN ALTERNATIVE INSTALLATION FOR APPROVAL BY THE CONTRACTOR.
9. SUBCONTRACTOR SHALL DETERMINE ACTUAL ROUTING OF CONDUIT, POWER AND T1 CABLES, GROUNDING CABLES AS SHOWN ON THE POWER, GROUNDING AND T1 PLAN DRAWING. SUBCONTRACTOR SHALL UTILIZE EXISTING TRAYS AND/OR SHALL ADD NEW TRAYS AS NECESSARY. SUBCONTRACTOR SHALL CONFIRM THE ACTUAL ROUTING WITH THE CONTRACTOR. ROUTING OF TRAYING SHALL BE APPROVED BY CONTRACTOR.
10. THE SUBCONTRACTOR SHALL PROTECT EXISTING IMPROVEMENTS, PAVEMENTS, CURBS, LANDSCAPING AND STRUCTURES. ANY DAMAGED PART SHALL BE REPAIRED AT SUBCONTRACTOR'S EXPENSE TO THE SATISFACTION OF OWNER.
11. SUBCONTRACTOR SHALL LEGALLY AND PROPERLY DISPOSE OF ALL SCRAP MATERIALS SUCH AS COAXIAL CABLES AND OTHER ITEMS REMOVED FROM THE EXISTING FACILITY. ANTENNAS REMOVED SHALL BE RETURNED TO THE OWNER'S DESIGNATED LOCATION.
12. SUBCONTRACTOR SHALL LEAVE PREMISES IN CLEAN CONDITION.
13. ALL CONCRETE REPAIR WORK SHALL BE DONE IN ACCORDANCE WITH AMERICAN CONCRETE INSTITUTE (ACI) 301.
14. ALL NEW CONCRETE NEEDED FOR THE CONSTRUCTION SHALL HAVE 4000 PSI STRENGTH AT 28 DAYS UNLESS OTHERWISE SPECIFIED. ALL CONCRETING WORK SHALL BE DONE IN ACCORDANCE WITH ACI 318 CODE REQUIREMENTS.
15. ALL STRUCTURAL STEEL WORK SHALL BE DONE IN ACCORDANCE WITH AISC SPECIFICATIONS.
16. CONSTRUCTION SHALL COMPLY WITH SPECIFICATION 25741-000-3495-002-0002, "GENERAL CONSTRUCTION SERVICES."
17. SUBCONTRACTOR SHALL VERIFY ALL EXISTING DIMENSIONS AND CONDITIONS PRIOR TO COMMENCING WORK. ALL DIMENSIONS OF EXISTING CONSTRUCTION SHOWN ON THE DRAWINGS MUST BE VERIFIED BY THE CONTRACTOR. THE CONTRACTOR SHALL BE RESPONSIBLE FOR ORDERING MATERIAL OR PROCEEDING WITH CONSTRUCTION.
18. THE EXISTING CELL SITE IS IN FULL COMMERCIAL OPERATION. ANY CONSTRUCTION WORK BY THE CONTRACTOR SHALL BE CONDUCTED IN ACCORDANCE WITH ALL APPLICABLE REGULATIONS. EQUIPMENT MUST BE COORDINATED WITH CONTRACTOR. ALSO, WORK MAY NEED TO BE SCHEDULED FOR AN APPROPRIATE MAINTENANCE WINDOW USUALLY IN LOW TRAFFIC PERIODS AFTER MIDNIGHT.
19. SINCE THE CELL SITE MAY BE ACTIVE, ALL SAFETY PRECAUTIONS MUST BE TAKEN WHEN WORKING AROUND HIGH LEVELS OF ELECTROMAGNETIC RADIATION. EQUIPMENT SHOULD BE SHUT DOWN PRIOR TO PERFORMING ANY WORK THAT COULD EXPOSE THE WORKERS TO DANGER. PERSONAL BE EXPOSURE MONITORS ARE REQUIRED TO BE WORN TO ALERT OF ANY DANGEROUS EXPOSURE LEVELS.
20. THE SUBCONTRACTOR SHALL NOT USE OR INSTALL ANY MATERIAL CONTAINING ASBESTOS OR LEAD PAINT CONTENT. THE USE OF SUCH MATERIAL IS STRICTLY PROHIBITED.
21. ALL EPOXY AND COATINGS SUBMITTALS SHALL BE APPROVED BY CITY PRIOR TO ACQUISITION BY CONTRACTOR. APPLICANT SHALL UTILIZE CITY APPROVED COATING CONTRACTOR. UTILITY SERVICES COMPANY, INC. (KEVIN BARNES)
22. ALL AFFECTED PORTIONS OF THE TANK SHALL BE PROTECTED, PROHIBITED AND COATED TO THE SATISFACTION OF THE CITY OF NAPA. PUBLIC WORKS-WATER DIVISION, ASK AND COATING LIMITS TO BE DETERMINED AND VERIFIED WITH THE CITY IN THE FIELD.


KEY NOTES:

1. EXISTING AT&T EQUIPMENT AREA - LOCATION OF SITE MODIFICATION
2. EXISTING AT&T PANEL ANTENNA AREA - LOCATION OF SITE MODIFICATION
3. EXISTING ACCESS DRIVEWAY (RIP)
4. EXISTING LANDSCAPING (RIP)
5. EXISTING ASPHALT DRIVE (RIP)
6. EXISTING SHAR LINK FENCE (RIP)
7. NEW 10'-0" HIGH CHAIN LINK FENCE WITH WAPA SLATS TO REPLACE EXISTING FENCE
8. EXISTING DIFFERENTIAL CONCRETE (RIP)
9. NEW CONCRETE DRIVEWAY TO BE BUILT TO THE EXISTING WATER TANK FOUNDATION. UNPAVED, UNFINISHED, FASTENED TO EXISTING CONCRETE PERIMETER

NOTES:

1. DO NOT SCALE DRAWINGS. ALL DIMENSIONS OF AND BETWEEN EXISTING BUILDINGS/STRUCTURES, OR RELATIVE DISTANCES AS SHOWN BETWEEN EXISTING BUILDINGS/STRUCTURES AND THE TRUE NORTH ARE TO BE CONFIRMED BY THE SURVEYOR.
2. POWER/TELECO ROUTING AND DESIGN ARE PRELIMINARY AND MUST BE VERIFIED WITH LOCAL UTILITY COMPANIES.


OVERALL SITE PLAN		GENERAL NOTES	
 AT&T MOBILITY 4130 REDWOOD DRIVE, BLDG 3 PLEASANTON, CA 94588	AWE - HWY 12/29 CCL00829 1542 FOSTER ROAD NAPA, CA 94558	DELTA GROUPS ENGINEERING, INC. CONSULTING ENGINEERS 5635 W LAS PAVAS BLVD., SUITE 403 NAPA, CA 94558 TEL: (707) 448-0115 FAX: (707) 448-0355	P128UBSD
SCALE: 1/16" = 1'-0" SHEET TITLE:		SHEET NO.: PROJECT NO.: DATE:	
OVERALL SITE PLAN & GENERAL NOTES		PROJECT NO.: 25471-630 SHEET NO.: A01 DATE: 7/11/13	

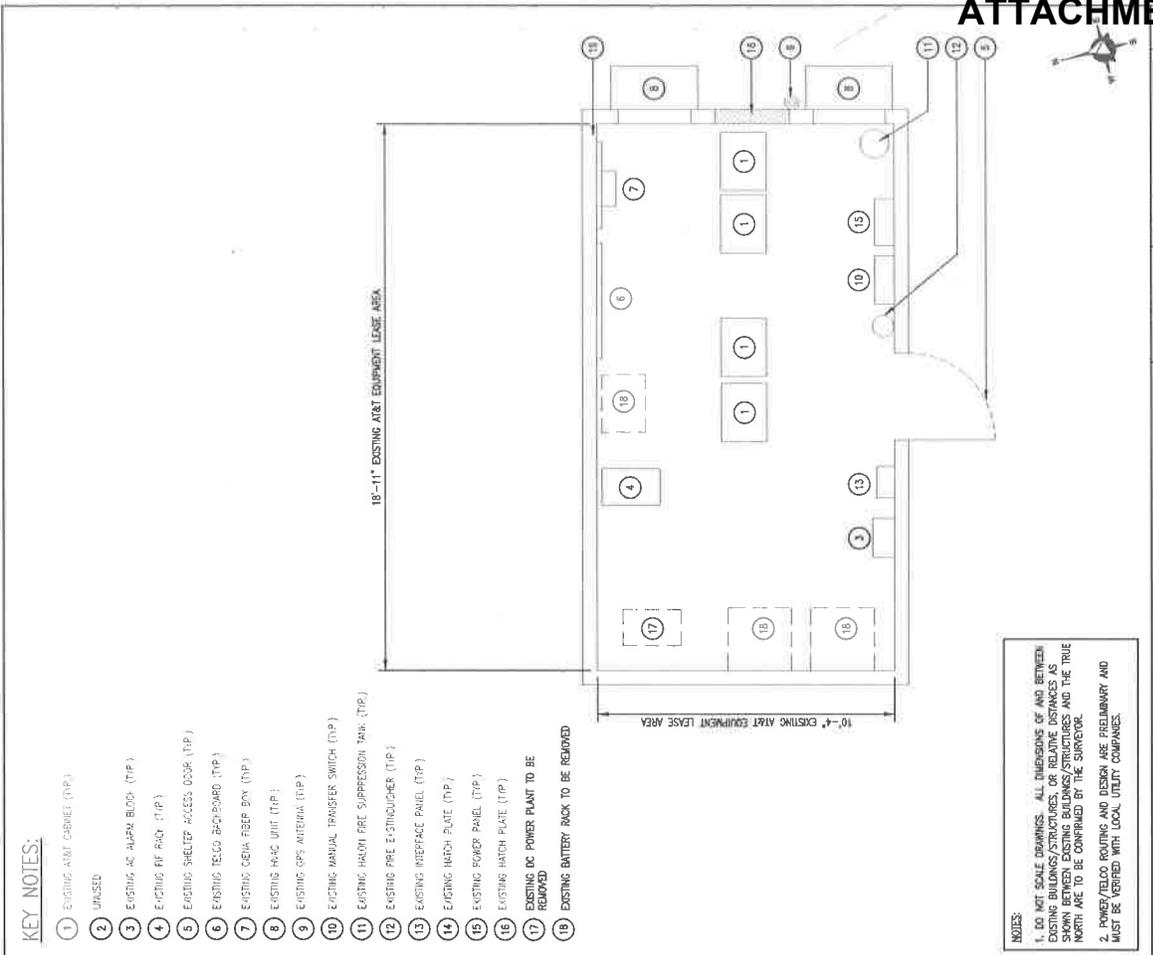

KEY NOTES:

- 1 EXISTING AT&T CABINET (TIP)
- 2 UNUSED
- 3 EXISTING AC ALPHA BLOC (TIP)
- 4 EXISTING REF RACK (TIP)
- 5 EXISTING SHELTER ACCESS DOOR (TIP)
- 6 EXISTING TEGO BACKBOARD (TIP)
- 7 EXISTING CEILING FIBER BOX (TIP)
- 8 EXISTING PDC UNIT (TIP)
- 9 EXISTING GPS ANTENNA (TIP)
- 10 EXISTING MANUAL TRANSFER SWITCH (TIP)
- 11 EXISTING HMI/FI FIRE SUPPRESSION TANK (TIP)
- 12 EXISTING FIRE EXTINGUISHER (TIP)
- 13 EXISTING INTERFACE PANEL (TIP)
- 14 EXISTING WASH PLATE (TIP)
- 15 EXISTING POWER PANEL (TIP)
- 16 EXISTING HATCH PLATE (TIP)
- 17 EXISTING DC POWER PLANT TO BE REMOVED
- 18 EXISTING BATTERY RACK TO BE REMOVED

NOTES:
 1. DO NOT SCALE DIMENSIONS. ALL DIMENSIONS OF AND BETWEEN EXISTING BUILDINGS/STRUCTURES, OR RELATIVE DISTANCES AS SHOWN BETWEEN EXISTING BUILDINGS/STRUCTURES AND THE TRUE NORTH ARE TO BE CONFIRMED BY THE SURVEYOR.
 2. POWER/TELECO ROUTING AND DESIGN ARE PRELIMINARY AND MUST BE VERIFIED WITH LOCAL UTILITY COMPANIES.

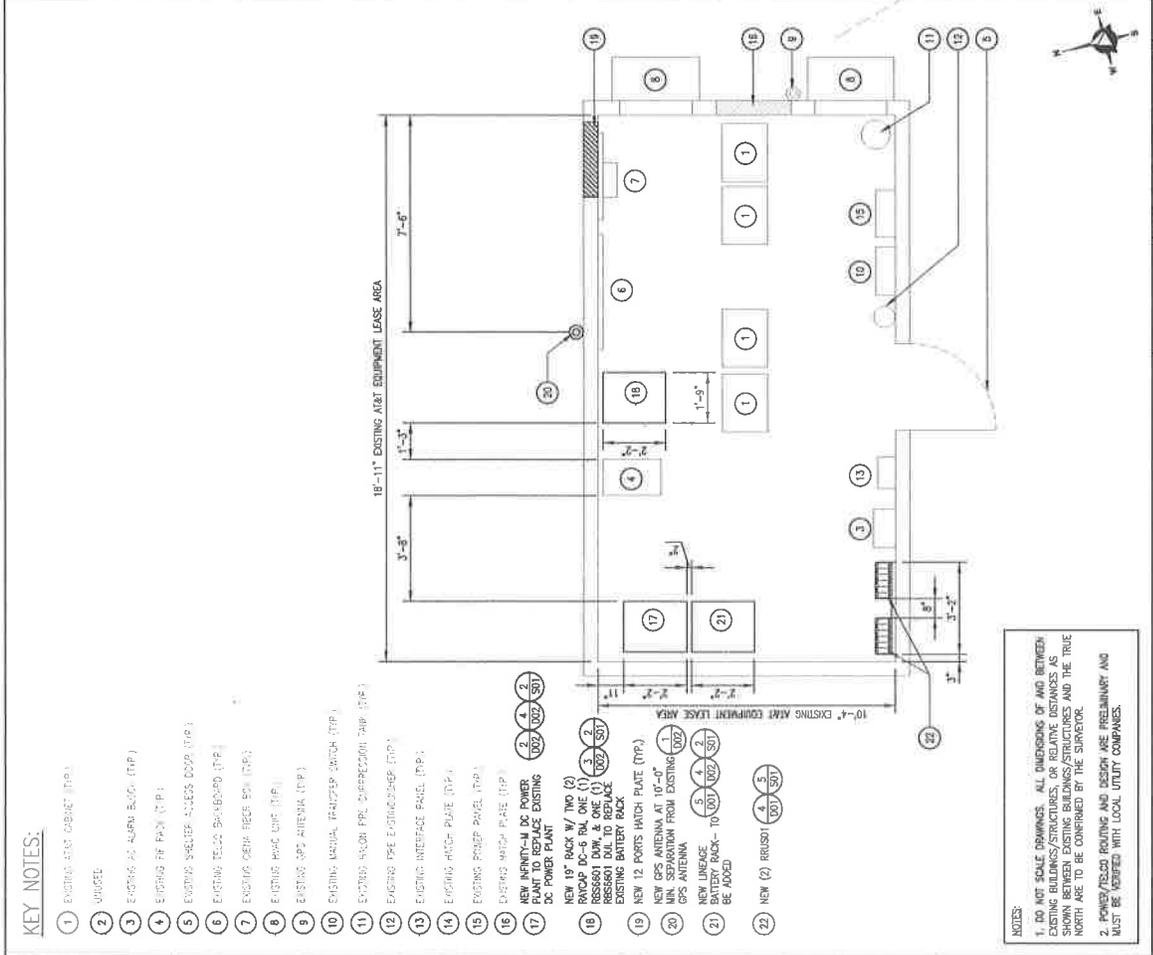


KEY NOTES:


- 1 EXISTING AT&T CABINET (TIP)
- 2 UNUSED
- 3 EXISTING AC ALPHA BLOC (TIP)
- 4 EXISTING REF RACK (TIP)
- 5 EXISTING SHELTER ACCESS DOOR (TIP)
- 6 EXISTING TEGO BACKBOARD (TIP)
- 7 EXISTING CEILING FIBER BOX (TIP)
- 8 EXISTING PDC UNIT (TIP)
- 9 EXISTING GPS ANTENNA (TIP)
- 10 EXISTING MANUAL TRANSFER SWITCH (TIP)
- 11 EXISTING HMI/FI FIRE SUPPRESSION TANK (TIP)
- 12 EXISTING FIRE EXTINGUISHER (TIP)
- 13 EXISTING INTERFACE PANEL (TIP)
- 14 EXISTING WASH PLATE (TIP)
- 15 EXISTING POWER PANEL (TIP)
- 16 EXISTING HATCH PLATE (TIP)
- 17 EXISTING DC POWER PLANT TO BE REMOVED
- 18 EXISTING BATTERY RACK TO BE REMOVED
- 19 NEW 19" RACK W/ TWO (2) RACKS DC-6 BUL ONE (1) W/ 12 PORTS HATCH PLATE (TIP) (002-002-301)
- 20 NEW GPS ANTENNA AT 10'-0" MIN. SEPARATION FROM EXISTING GPS ANTENNA (002-002-301)
- 21 NEW LINKAGE BATTERY RACK- 10 (001-002-301) BE ADDED
- 22 NEW (2) RRU/SOT (001-001-301)

NOTES:
 1. DO NOT SCALE DIMENSIONS. ALL DIMENSIONS OF AND BETWEEN EXISTING BUILDINGS/STRUCTURES, OR RELATIVE DISTANCES AS SHOWN BETWEEN EXISTING BUILDINGS/STRUCTURES AND THE TRUE NORTH ARE TO BE CONFIRMED BY THE SURVEYOR.
 2. POWER/TELECO ROUTING AND DESIGN ARE PRELIMINARY AND MUST BE VERIFIED WITH LOCAL UTILITY COMPANIES.



	<p>at&t</p> <p>AT&T MOBILITY 4400 REDWOOD DRIVE, BLDG. 3 PLEASANTON, CA 94588</p>	<p>AWE - HWY 12/29 CCL00829 1542 FOSTER ROAD NAPA, CA 94558</p>	<p>DELTA GROUPS ENGINEERING, INC. CONSULTING ENGINEERS</p> <p>3000 W LAS PASTORIS BLVD., SUITE 403 SAN ANTONIO, TEXAS 78201 TEL: (825) 482-0115 FAX: (825) 488-0355</p>	<p>EXISTING EQUIPMENT AREA PLAN</p> <p>SCALE: 1/2" inch = 1' ft</p> <p>DATE: 12/11/13</p> <p>ISSUED FOR CONSTRUCTION</p> <p>DATE: 12/11/13</p> <p>ISSUED FOR CONSTRUCTION</p> <p>DATE: 12/11/13</p> <p>ISSUED FOR CONSTRUCTION</p>
<p>NEW EQUIPMENT AREA PLAN</p> <p>SCALE: 1/2" inch = 1' ft</p> <p>DATE: 12/11/13</p> <p>ISSUED FOR CONSTRUCTION</p> <p>DATE: 12/11/13</p> <p>ISSUED FOR CONSTRUCTION</p> <p>DATE: 12/11/13</p> <p>ISSUED FOR CONSTRUCTION</p>	<p>EXISTING / NEW EQUIPMENT AREA PLAN</p> <p>SCALE: 1/2" inch = 1' ft</p> <p>DATE: 12/11/13</p> <p>ISSUED FOR CONSTRUCTION</p> <p>DATE: 12/11/13</p> <p>ISSUED FOR CONSTRUCTION</p> <p>DATE: 12/11/13</p> <p>ISSUED FOR CONSTRUCTION</p>	<p>PROJECT NO: 25471-630</p> <p>JOB NO: TT1-CCL00829</p> <p>DATE: 12/11/13</p> <p>ISSUED FOR CONSTRUCTION</p>	<p>PROJECT NO: P12BL080</p> <p>DATE: 12/11/13</p> <p>ISSUED FOR CONSTRUCTION</p>	

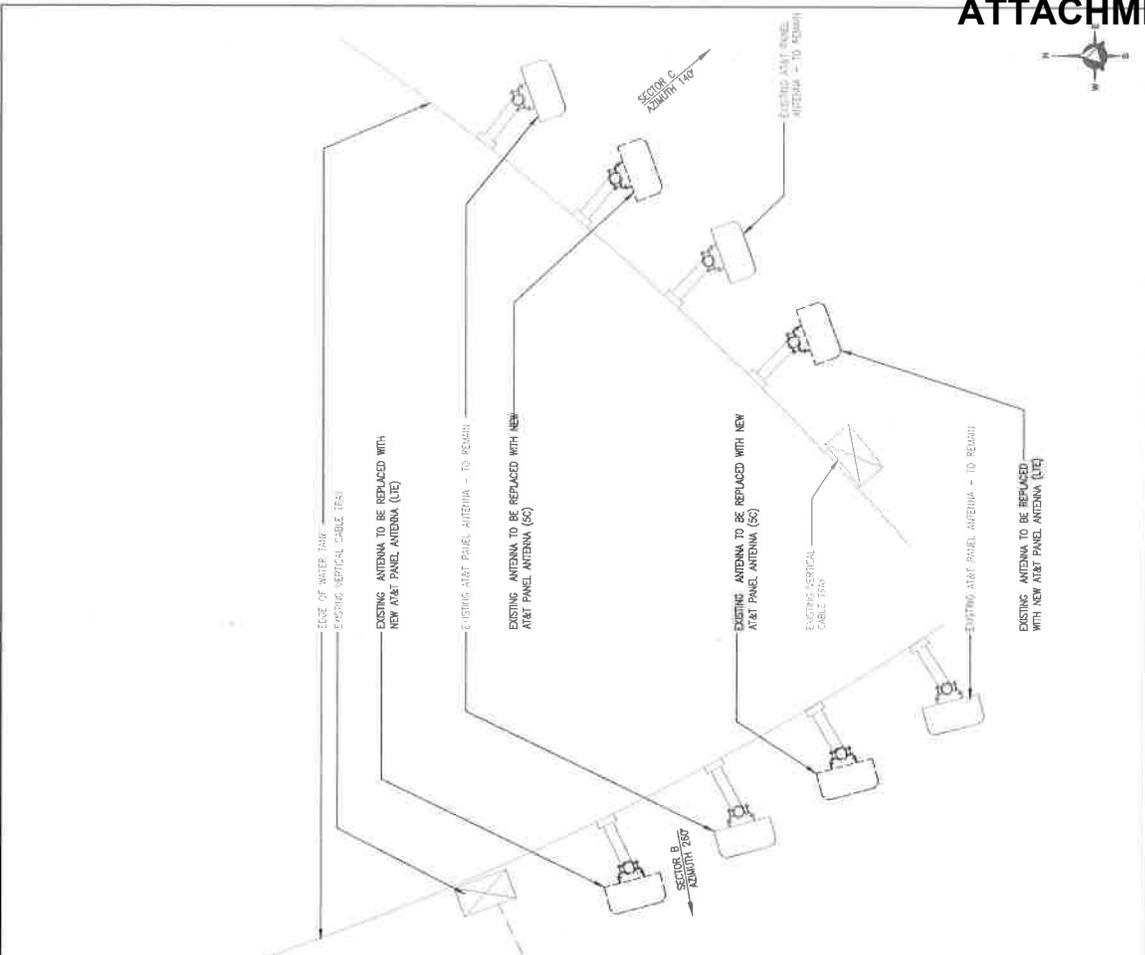

- NOTES:**
1. ALL PANEL ANTENNAS AND EQUIPMENTS SHALL BE PAINTED TO MATCH EXISTING WATER TANK.
 2. NEW COATING AREA UNITS SHALL BE FULL HEIGHT OF TANK AND SPAN A MINIMUM OF 2 FEET. COATING SHALL BE APPLIED TO ALL EXPOSED SURFACES OF WATER TANK AT LEAST ONE FOOT FROM UPWARDS FROM TANK PAD (INTENDED TO COAT ALL AREAS WHERE NEW UNISTRUT IS INSTALLED ON FACE OF TANK. ALL COATING PORTION(S) OF WORK SHALL BE CONDUCTED BY UTILITY SERVICES COMPANY, INC. (KEVIN BARNES).

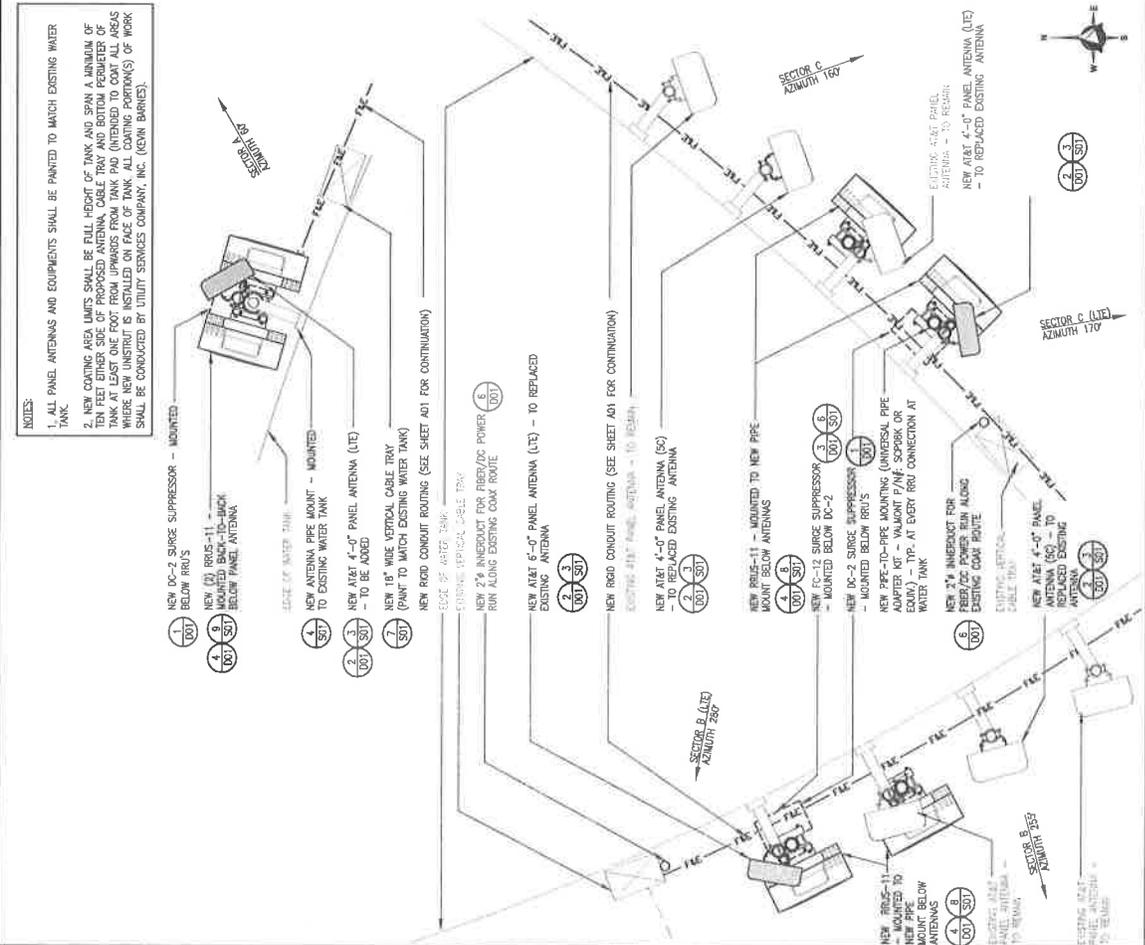

NEW ANTENNA LAYOUT		EXISTING ANTENNA LAYOUT	
DATE	25471-630	DATE	TT1-CCLO0829
SCALE	1 inch = 1 ft	SCALE	1 inch = 1 ft
DESIGNED BY	DESIGNED	DESIGNED BY	DESIGNED
CHECKED BY		CHECKED BY	
APPROVED BY		APPROVED BY	
PROJECT NO.	A03	PROJECT NO.	A03
<p>AT&T MOBILITY 4130 ROSSWOOD DRIVE, BLDG. 3 FOLSOM, CA 94508</p>		<p>AWM - HWY 12/29 CCLO0829 1542 FOSTER ROAD NAPA, CA 94558</p>	
<p>DELTA GROUPS ENGINEERING, INC. CONSULTING ENGINEERS</p> <p>NEW 1115 DELTA GROUPS ENGINEERING, INC., SUITE 403 PLEASANTON, CA 94566 TEL: (925) 466-0715 FAX: (925) 466-0365</p>		<p>P12BLO60</p>	

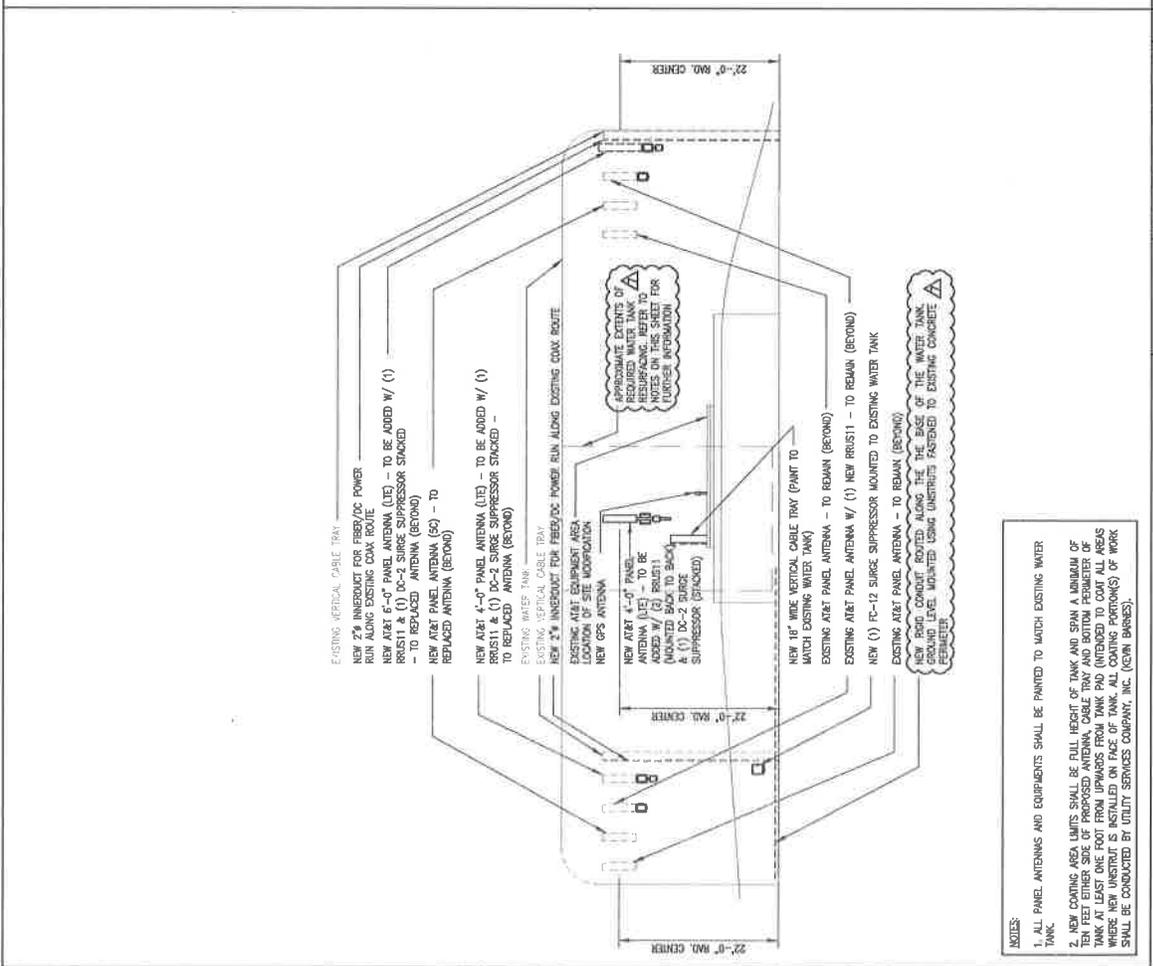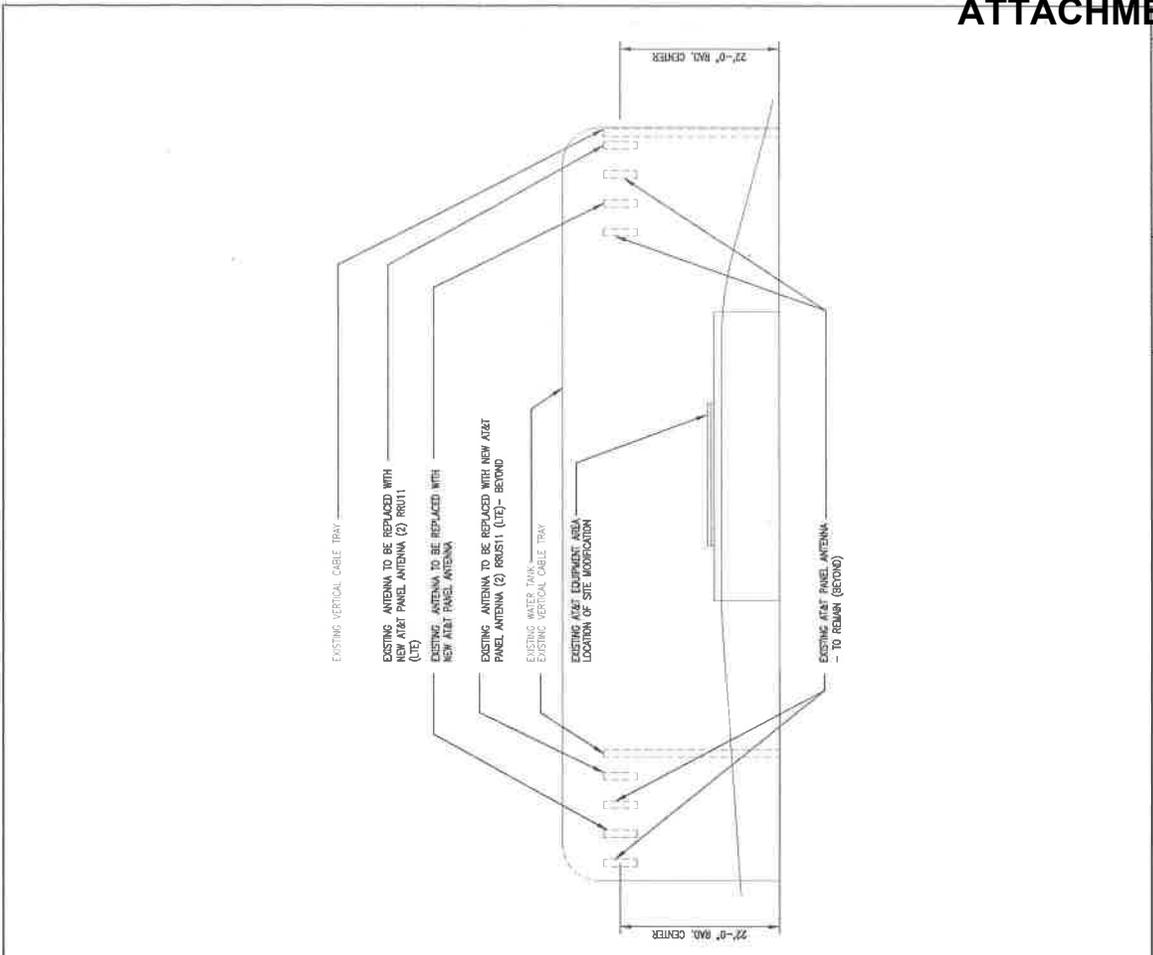

- NOTES:
1. ALL PANEL ANTENNAS AND EQUIPMENTS SHALL BE PAINTED TO MATCH EXISTING WATER TANK.
 2. NEW COAXING AREA LIMITS SHALL BE FULL HEIGHT OF TANK AND BEHIND A MINIMUM OF TEN FEET EITHER SIDE OF PROPOSED ANTENNA CABLE TRAY AND BOTTOM FEETWEAR OF TANK AT LEAST ONE FOOT FROM UPWARDS FROM TANK PAD (INTENDED TO COAT ALL AREAS WHERE NEW UNISTRUT IS INSTALLED ON FACE OF TANK. ALL COATING PORTION(S) OF WORK SHALL BE CONDUCTED BY UTILITY SERVICES COMPANY, INC. (UCVIR BARNEYS).

NEW NORTH ELEVATION		EXISTING NORTH ELEVATION	
SCALE: 1/8" INCH = 1' - 0"		SCALE: 1/8" INCH = 1' - 0"	
DOE LIA. NUMBER: P12BL060		AWE - HWY 12/29 CCL00829 1542 FOSTER ROAD NAPA, CA 94558	
 DELTA GROUPS ENGINEERING, INC. CONSULTING ENGINEERS 5600 W LAS PAVAS BLVD., SUITE 403 NAPA, CA 94558 TEL: (707) 468-0715 FAX: (707) 468-0305		 AT&T MOBILITY 4400 RIVERSIDE DRIVE, BLDG. 3 PLEASANTON, CA 94888	
DATE: 12/17/13	BY: JTM/MS	DATE: 12/17/13	BY: JTM/MS
ISSUED FOR CONSTRUCTION	REVISIONS	ISSUED FOR CONSTRUCTION	REVISIONS
3/10/13		3/10/13	
8/7/13		8/7/13	
4/26/13		4/26/13	
PROJECT: 25471-630	PROJECT: 25471-630	PROJECT: 25471-630	PROJECT: 25471-630
SHEET NO: A04	SHEET NO: A04	SHEET NO: A04	SHEET NO: A04
DRAWN: JT		DRAWN: JT	

